
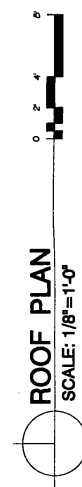


All blue are keyed the same. 16 keys supplied.

Remove cylinders  
Install dummy cylinders  
always open-no key

Repair strike  
Install basic cylinder

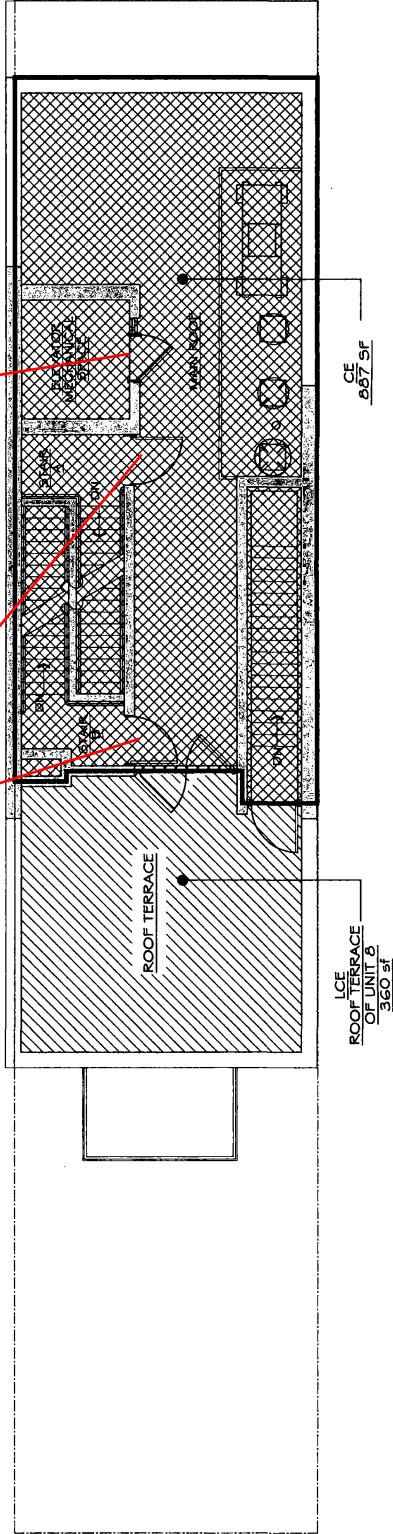

- UNIT TAXLOT
- LIMITED COMMON ELEMENT LCE
- COMMON ELEMENT CE

**STATEMENT OF DIMENSIONS:**  
DIMENSIONS INDICATED ARE APPROXIMATE AND ARE LOCATED HORIZONTALLY, APPROXIMATELY TO THE EXTERIOR OF EXTERIOR WALL OF THE BUILDING, AND PARTITIONS DIVIDING THE UNITS FROM CORRIDORS, STAIRS AND MECHANICAL SPACES).  
DIMENSIONS SHALL BE TO THE CENTER LINE WHEN A PARTITION DIVIDES TWO (2) UNITS.

**DECLARANT:**  
534 West 42nd Street, LLC  
ADDRESS : 534 WEST 42ND ST  
NEW YORK, NY 10036

**ARCHITECTS CERTIFICATION:**  
STATE OF NEW YORK,  
COUNTY OF MANHATTAN

THIS IS TO CERTIFY THAT THIS PLAN IS AN ACCURATE REFLECTION OF THE AS BUILT CONDITIONS OF THE BUILDING AND FULLY AND FAIRLY DEPICTS THE LAYOUT, LOCATION, UNIT DESIGNATION AND APPROXIMATE DIMENSIONS OF THE UNITS.

**ARCHITECT:**  
BRIAN E BOYLE, RA

ELI B. SINGER TO BEFORE ME;  
JERRY PUBLIC NOTARY  
No. 01BR6141234  
Qualified in Kings County  
Commission Expires Feb-24-2016

**ARCHITECT:**  
BRIAN E BOYLE, AIA  
75 SPRING STREET, 6TH FLR  
NEW YORK, NY 10012

**The Deuce Condominium**  
534 WEST 42ND ST  
NEW YORK, NY 10036

**TAX LOT CERTIFICATION:**  
THE UNIT DESIGNATION AND THE TAX LOT NUMBERS SHOWN HEREON CONFORM TO THE MAPS OF THE REAL PROPERTY ASSESSMENT BUREAU OF THE CITY OF NEW YORK, BOROUGH OF MANHATTAN

DATED: 9-10-12  
CARTOGRAPHER: [Signature]

SHEET 12 OF 13

