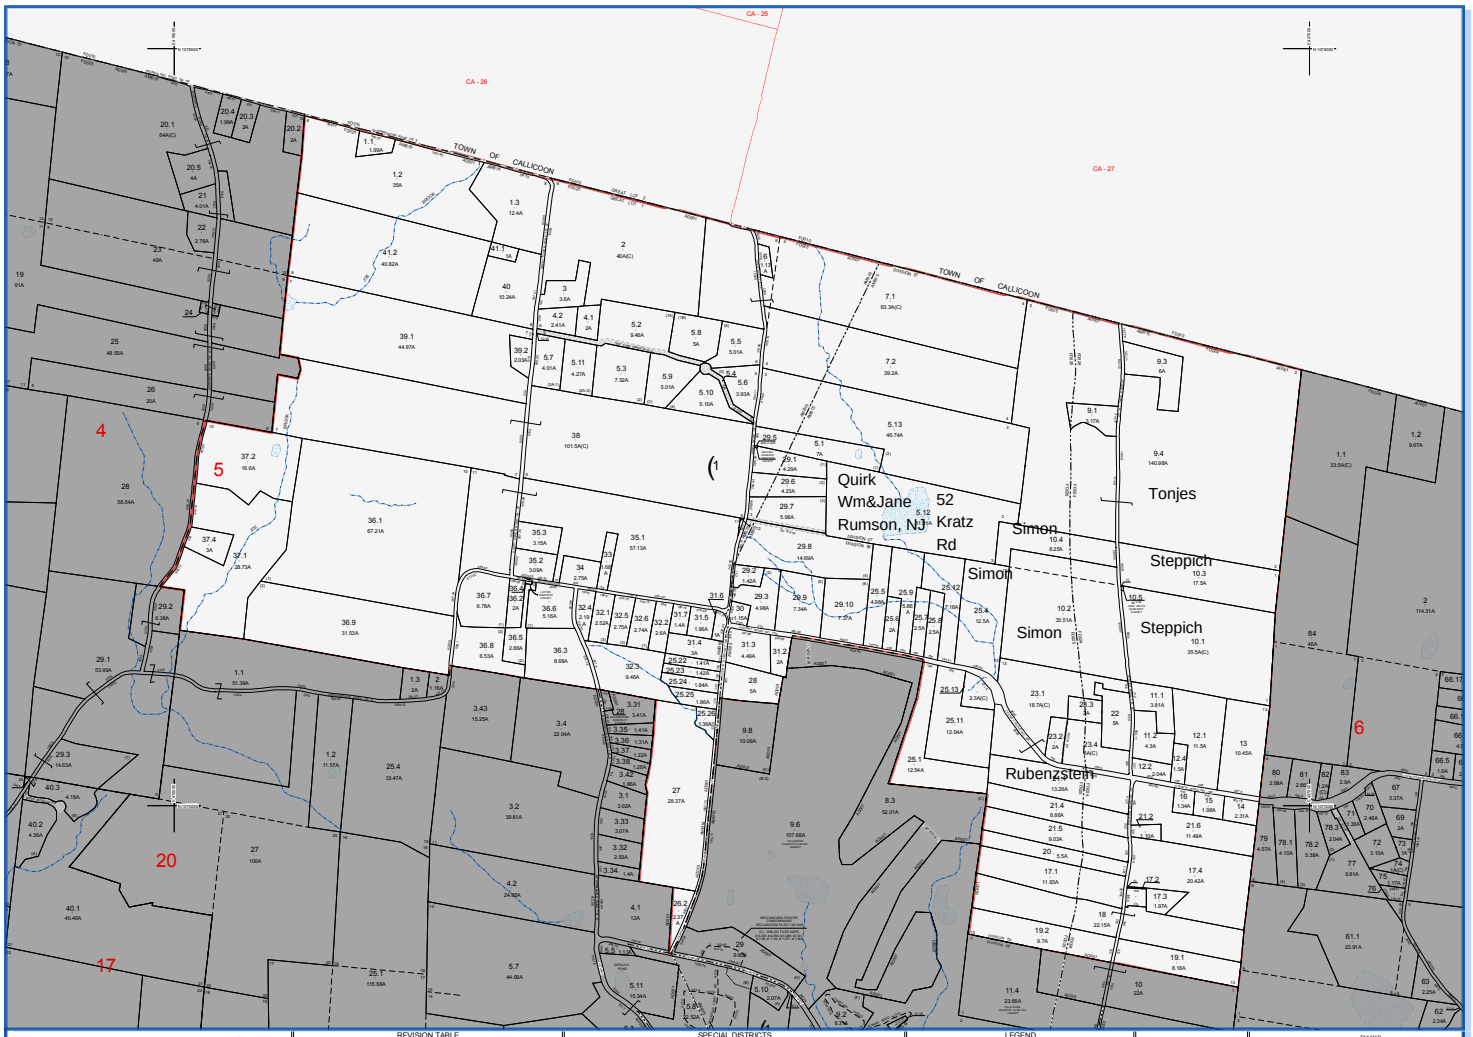

SULLIVAN COUNTY
TAX MAP DEPARTMENT
FOR TAX PURPOSES ONLY
NOT TO BE USED FOR CONVEYANCE
LIKENESS APPLIES ONLY TO THE UNDAMAGED PORTION OF THE MAP
North American Datum 1983, New York East

Office of Real Property Services
Sullivan County Government Center
100 North St, Monticello, NY 12701
Phone: (845) 807-0021

REVISION TABLE

DATE	CHANGES	DATE	CHANGES
9/20/19	Converted into DB data format		

SPECIAL DISTRICTS

TYPE	SYMBOL	NAME	ABLM NO.	TYPE	SYMBOL	NAME	ABLM NO.
SCHOOL	BCH	BULLOWA WEST CENT SCH DIST	BUWS				
AMBULANCE	AMB	UPPER DEL VALLEY AMB. CORP	AMB19				
AGRICULTURAL	AG	AG DIST #1	AGD01				
FIRE	FD	HORTONVILLE	FD028				
FIRE	FD	JEFFERSONVILLE	FD038				
AMBULANCE	AMB	AMB. DIST #1	AMB19				

LEGEND

STATE OR COUNTY LINE		TAX MAP BLOCK NO.	
CITY TOWN OR VILLAGE LINE		FILED PLAN LOT NO.	
BLOCK LINE		FILED PLAN BLOCK NO.	
SPECIAL DISTRICT LINE		TAX MAP LOT NO.	12
EASEMENT LINE		AREA (Front Deed)	10.85
PROPERTY LINE		AREA (Calculated)	10.84(C)
FILED PLAN LOT LINE		DIMENSION (Front Deed)	**
RIVERS' LINE		DIMENSION (Deed)	**
WATCH LINE		ATTENTION	

SECTION INDEX

TAX MAP
TOWN OF DELAWARE
SULLIVAN COUNTY, NEW YORK
North American datum 1983, State Plane New York East Feet

Photo No. 84-146-8-3 Date of Map 2/2/1988
Date of Photo 08/1984 Scale 1" = 400'
Section No. 5